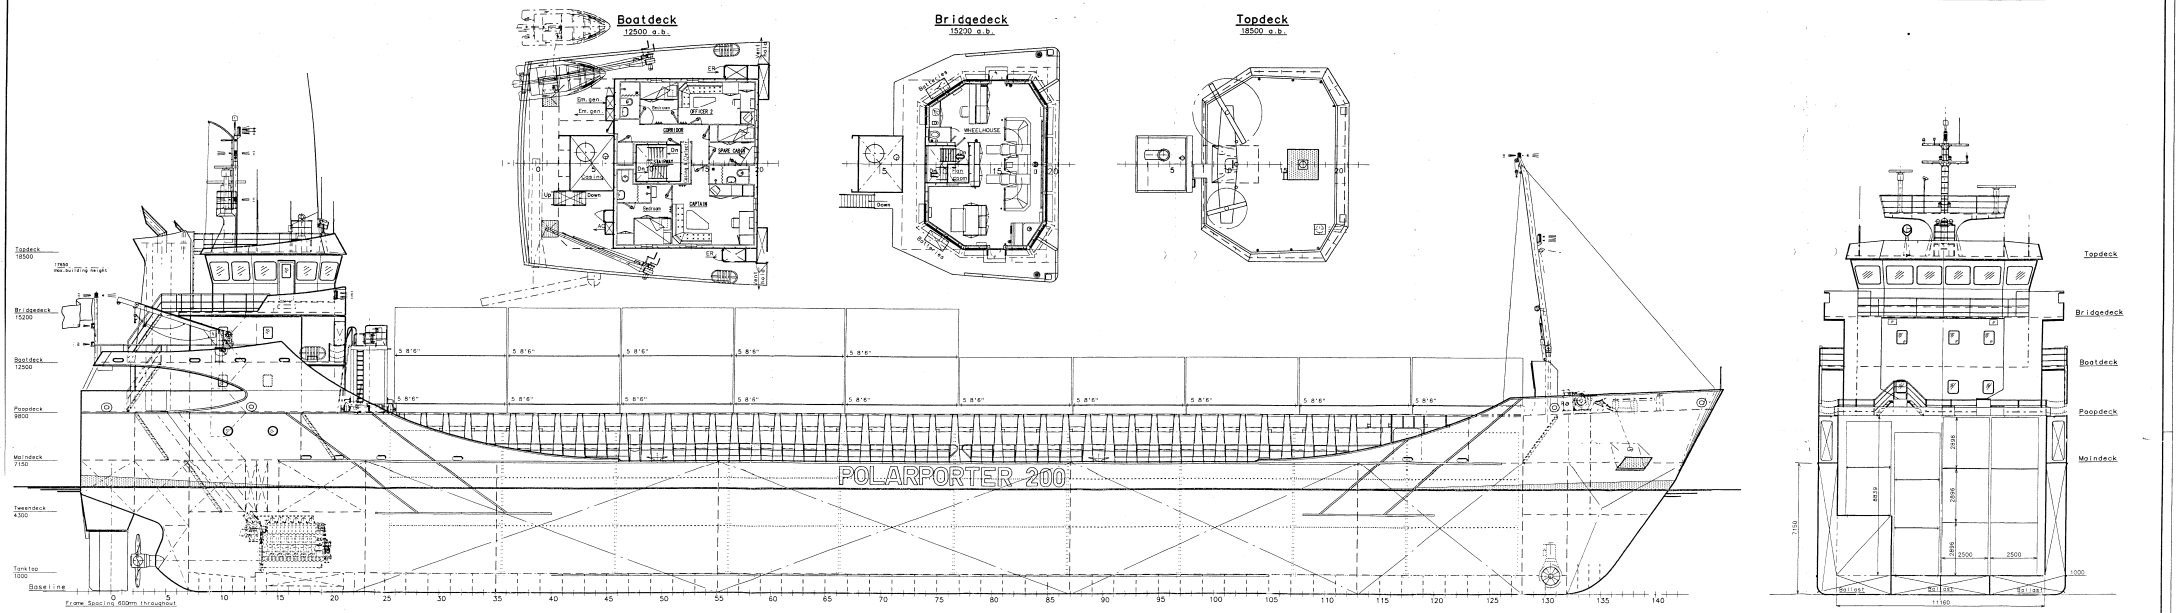


MAIN DIMENSIONS

| | | |
|---|---|---|
| Length o.a. | | 89.25 m |
| Length pp (85% D) | | 84.95 m |
| Breadth max. | | 13.40 m |
| Breadth mld. | | 13.30 m |
| Depth | | 7.15 m |
| Drught max. | | 5.66 m |
| Deadweight | app. | 3780 tdw |
| Holdcap. | app. | 206000 cft |
| Container in Hold 106 TEU or 48FEU + 10 TEU on Hatch 75 TEU or 35FEU | | |
| Service Speed | ca. | 12 kn |
| Engine | MaK 6M25 | 1800 kW |
| GT | app. | 2785 |
| NT | app. | 1601 |

Class: Bureau Veritas
I 3/3E * Cargo/Container ship + ACA
Deep Sea Ice Class 1A Heavy Cargo

NSI 0 mans wachtbezetting richtlijn 37
onbeperkte vaart

| No. | Remarks | By | Date |
|---|---|---|---|
| H | As built | JHW | 06-04-00 |
| G | According to crf. drawings | JHW | 24-01-00 |
| F | Remarks VEC | JHW | 17-08-99 |
| E | Remarks VEC | JHW | 06-08-99 |
| D | Remarks VEC | JHW | 30-03-99 |
| C | Remarks yard/owner | JHW | 04-03-99 |
| B | Remarks yard/vec. | JHW | 19-02-99 |
| A | Remarks Yard | JHW | 11-02-99 |

DRAWING

VUYK ENGINEERING CENTER

CH
CH P.I.
VEC Proj. 1347
C Drwnr. 0001
Scale 1:100
Drawn JHM
Class Appr. date
Auth. Appr. date
Date 16-10-98

PCP 200-B

Size

General Arrangement

Nr. of 1
Sheet 1

NOTICE : This drawing and the information it contains are the property of VUYK ENGINEERING GRONINGEN B.V. and may not be reproduced or used in part or in whole for any purpose except by written permission of this company.

PETERS
SHIPYARD PETERS B.V.
NEWBUILDING of SHIPS
P.O. Box 291 8260 AG Kampen
Tel.:038-3315023 Fax.:038-3311162

Buildnr.: 450/463-467
Drwnr.: 6200
Rev.nr. H

Drawing: 4013347/001/tek-001-3-001.mod

Plotdate: 04-05-2000 14:28:02